


IF THIS DIMENSION DOES NOT MEASURE ONE INCH (1") EXACTLY, THIS DRAWING
1" ACTUAL
HAS BEEN ENLARGED OR REDUCED, AFFECTING ALL LABELED SCALES

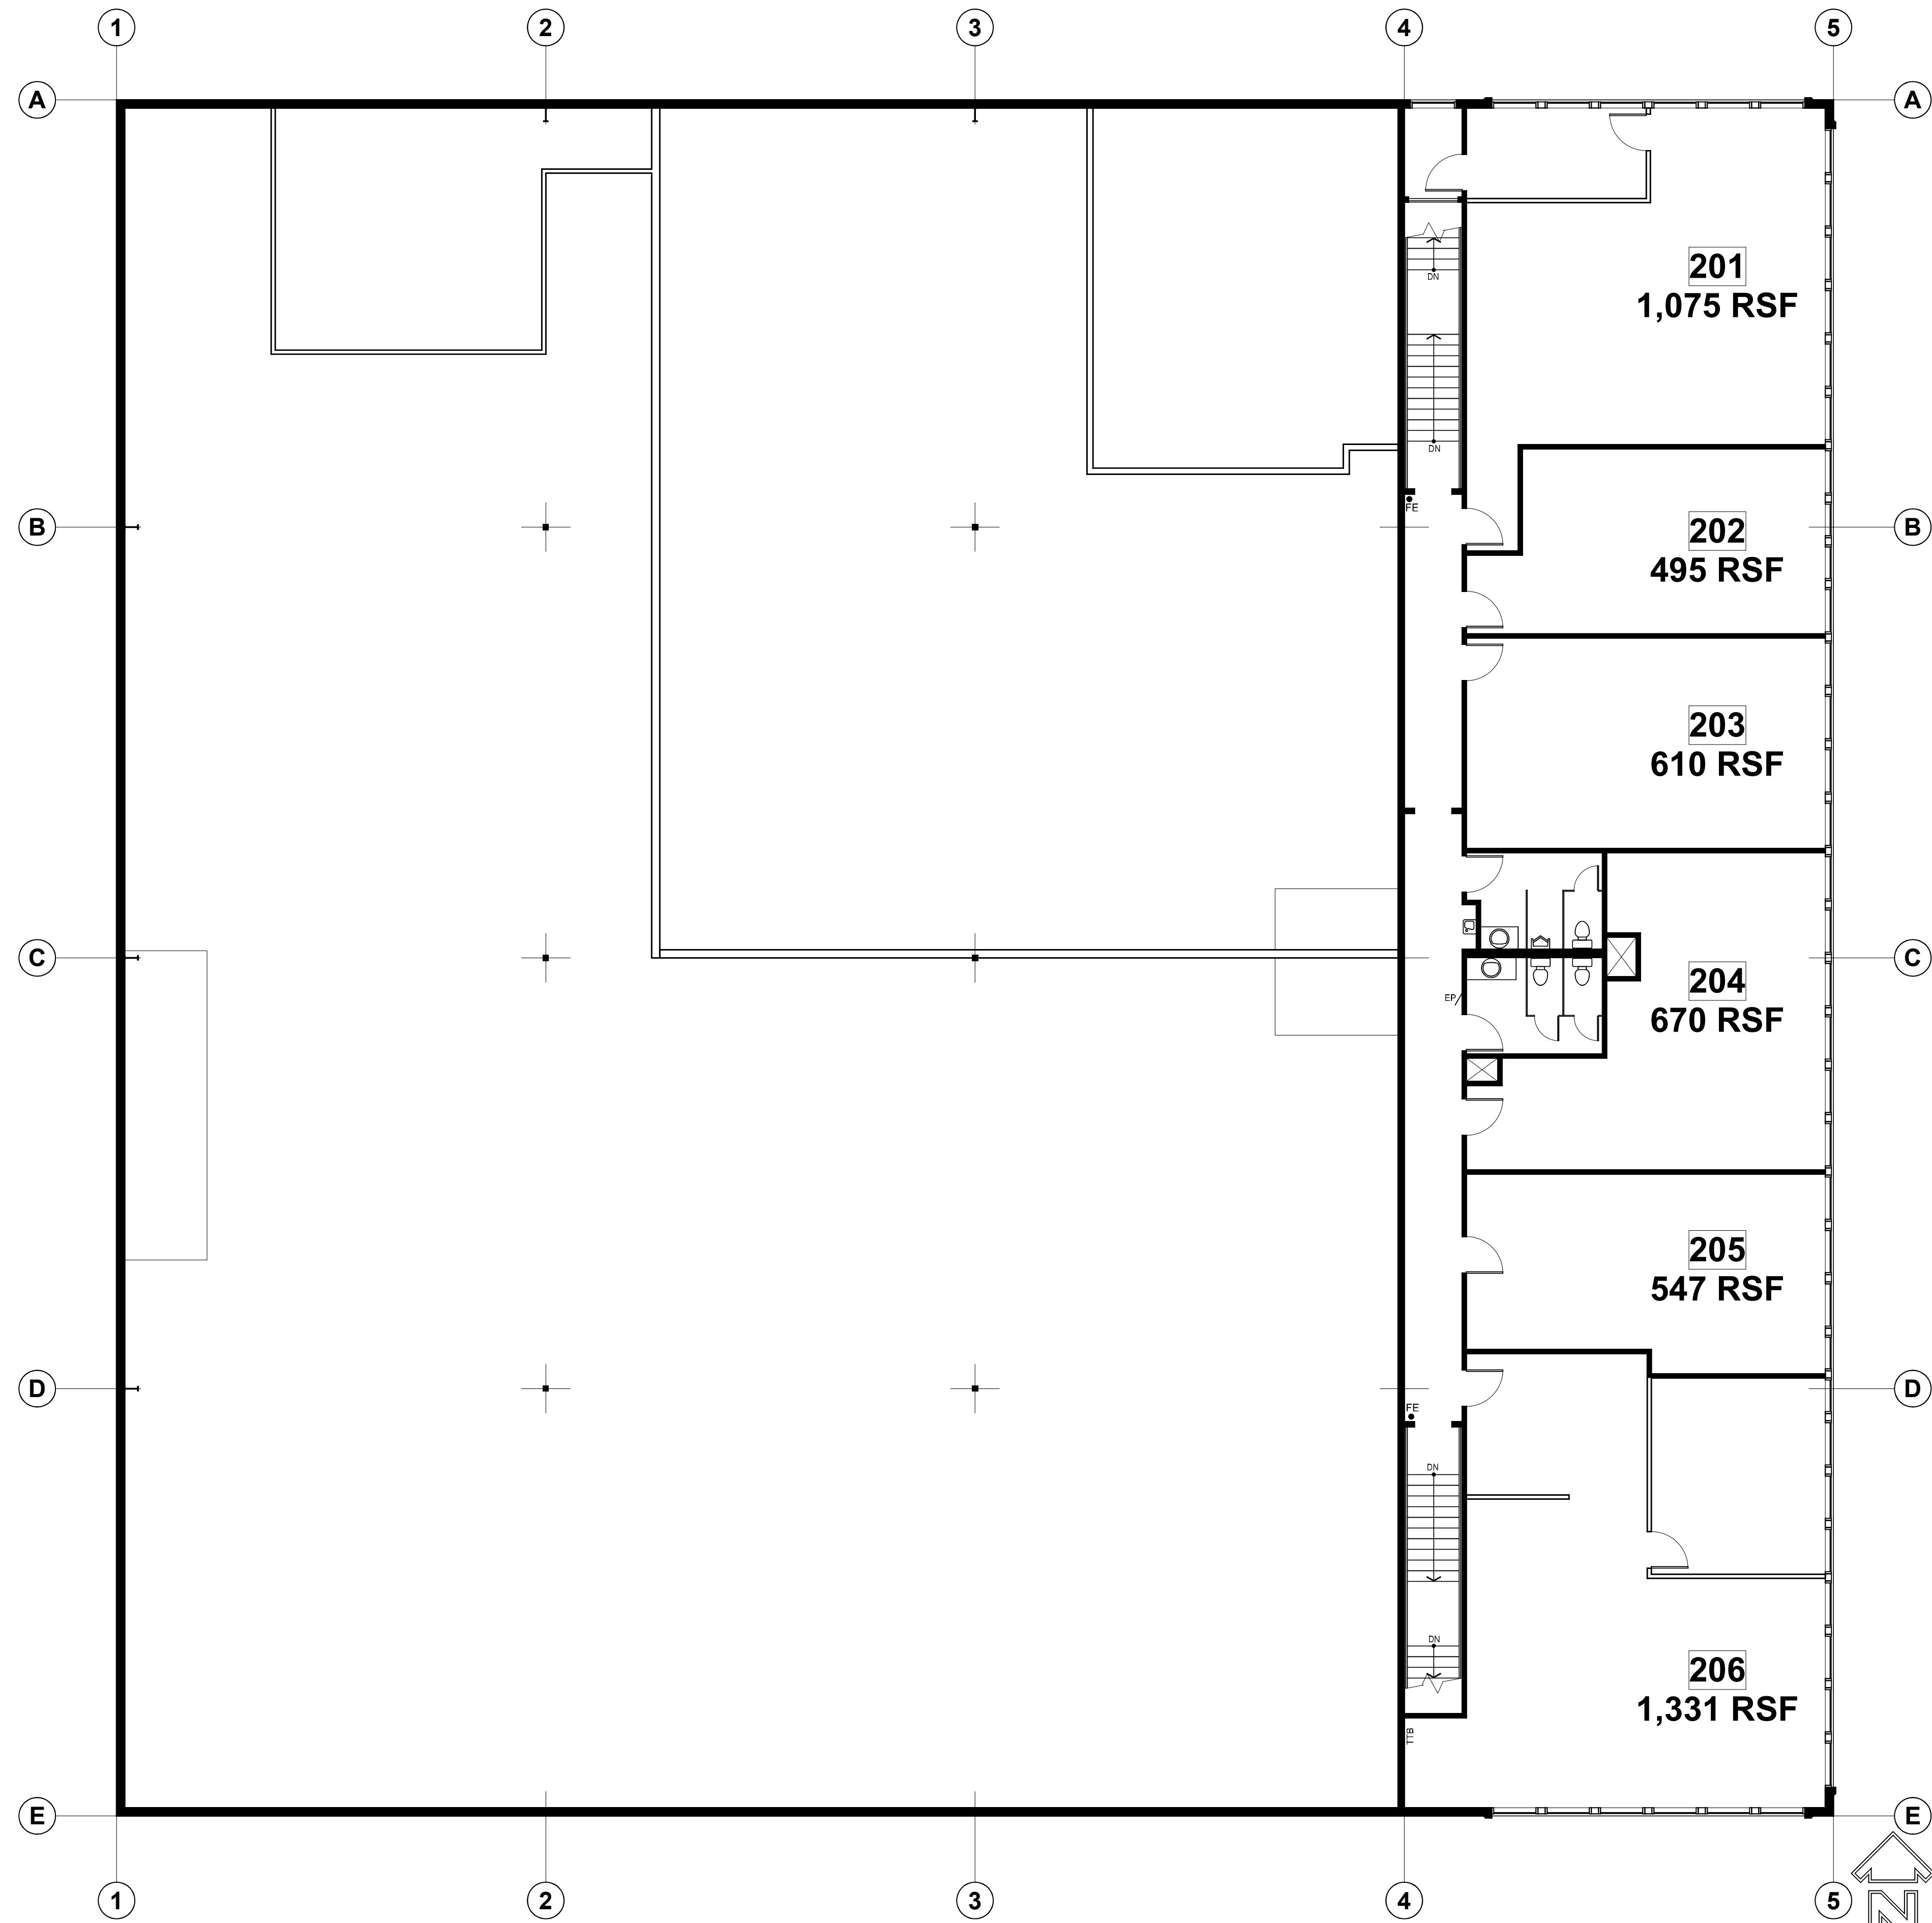

FLOOR 2 PLAN

SCALE:
1:96
1/8"=1'-0"

Deliverable: 03/28/2019

FLOOR 2 PLAN
 'AS-BUILT' DRAWING FOR:
7120 OLD SEWARD HIGHWAY
 ANCHORAGE, ALASKA
 PREPARED FOR APRIA HEALTHCARE

CONSULTANT:

PROJECT NO: 2009-011
 DATE: 03/28/2019
 DRAWN BY: DDM
 CHECKED BY: -
 REVISIONS: -

Symbol	Description	Date

AB
2

BETTISWORTH NORTH ARCHITECTS & PLANNERS ©

BETTISWORTH NORTH
 ARCHITECTURE PLANNING LANDSCAPE INTERIORS

2600 DENALI STREET SUITE 710 ANCHORAGE, ALASKA 99503 (907) 561-5780
 212 FRONT STREET FAIRBANKS, ALASKA 99701 (907) 456-5780
 CORPORATE No. AECC219 WWW.BETTISWORTHNORTH.COM