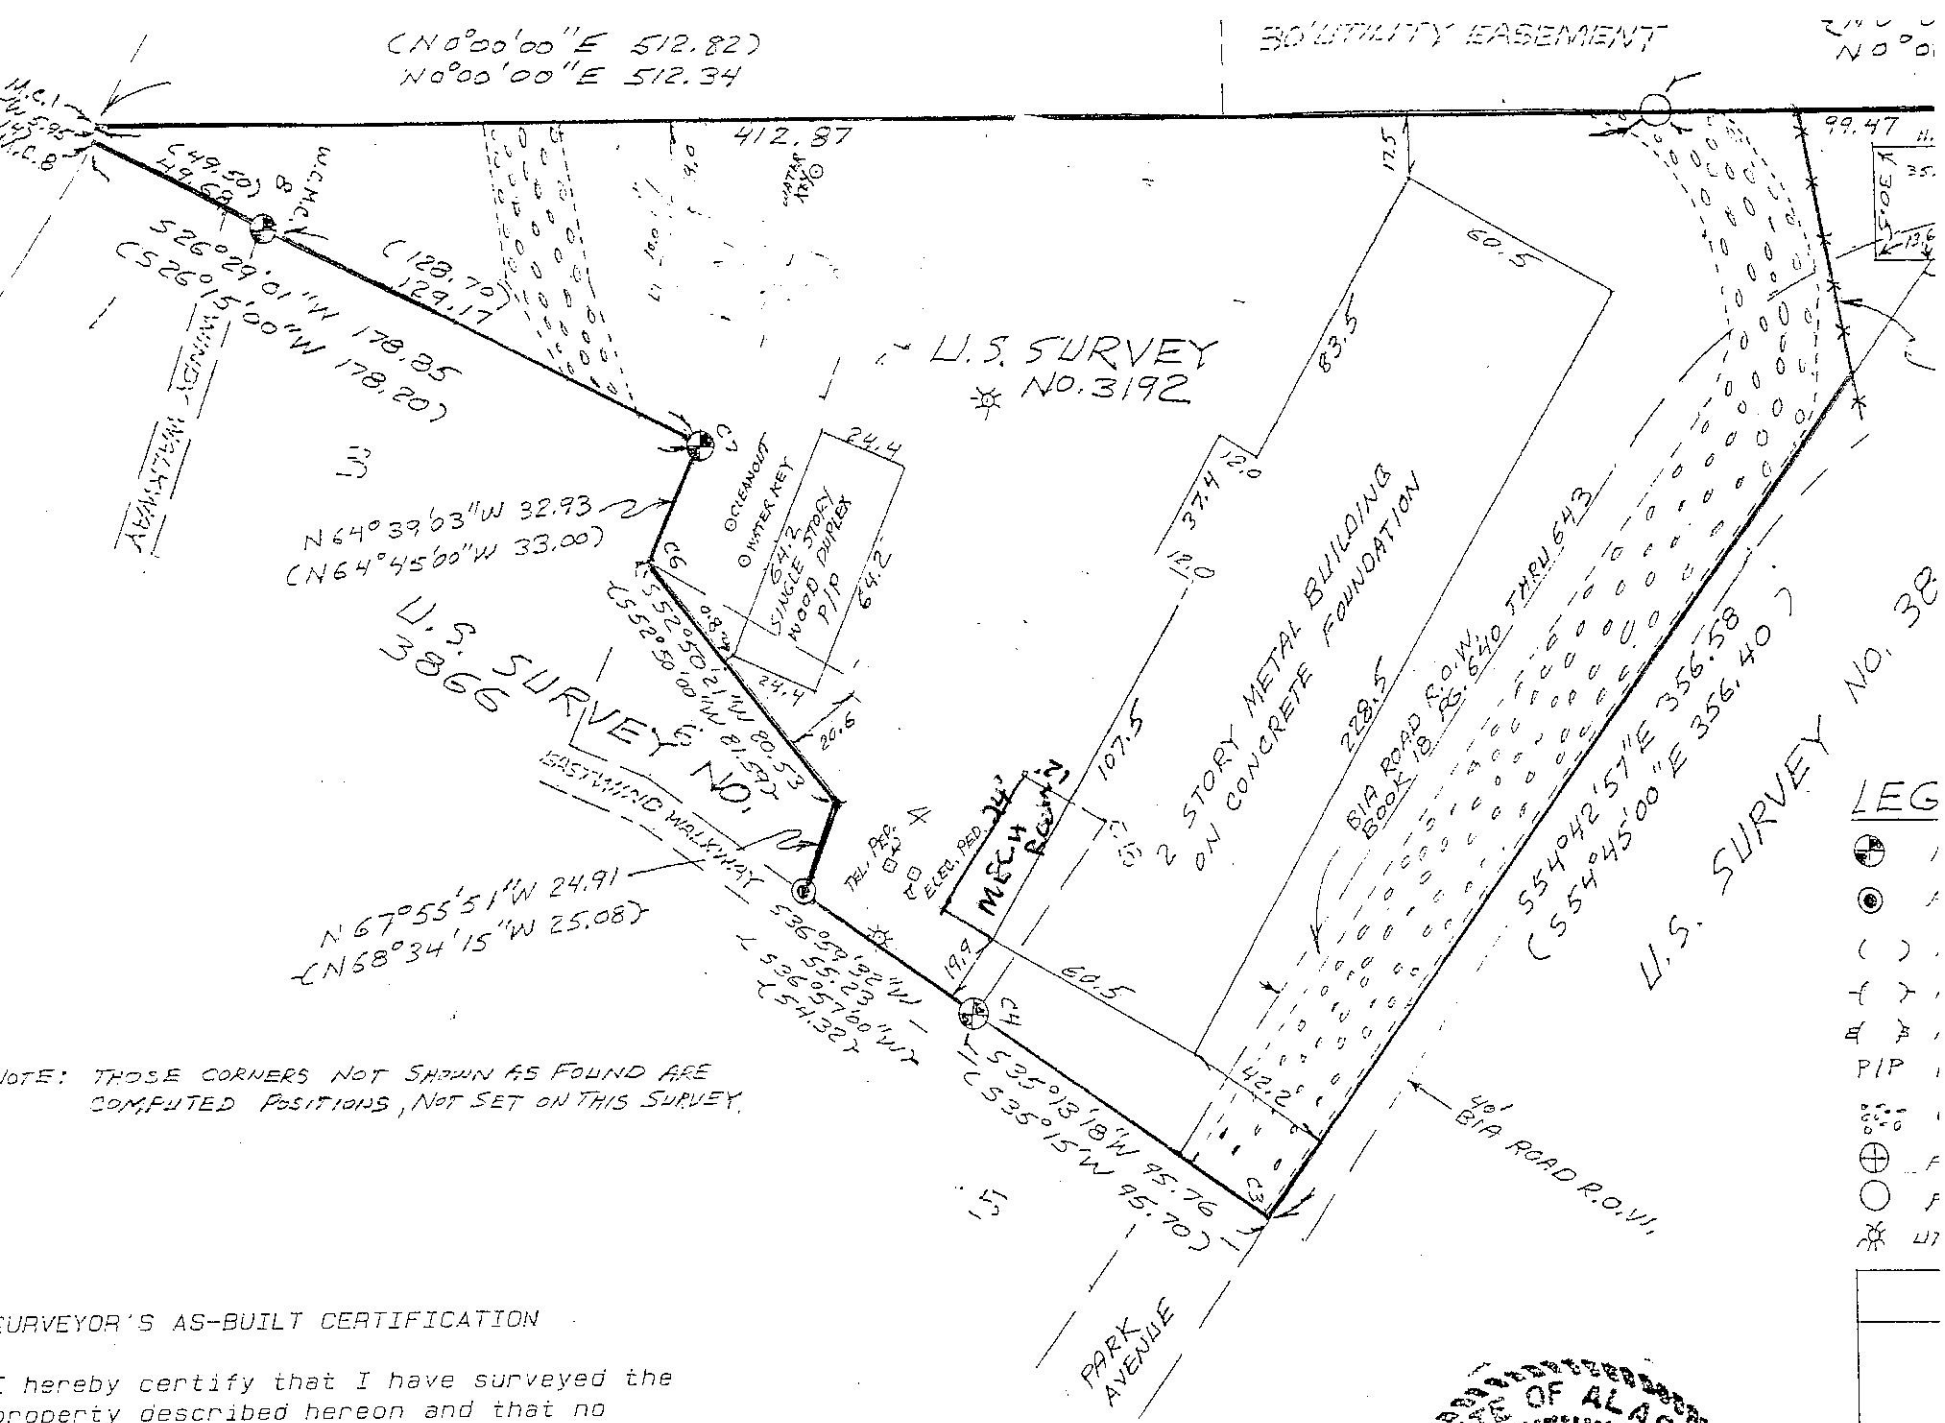

NOTE: THOSE CORNERS NOT SHOWN AS FOUND ARE COMPUTED POSITIONS, NOT SET ON THIS SURVEY.

SURVEYOR'S AS-BUILT CERTIFICATION

I hereby certify that I have surveyed the property described hereon and that no encroachments exist except as heron indicated.

EXCLUSION NOTE:

It is the responsibility of the owner to determine the existence of easements, covenants

STATE OF ALASKA
49TH
Lyle C. Higgins